



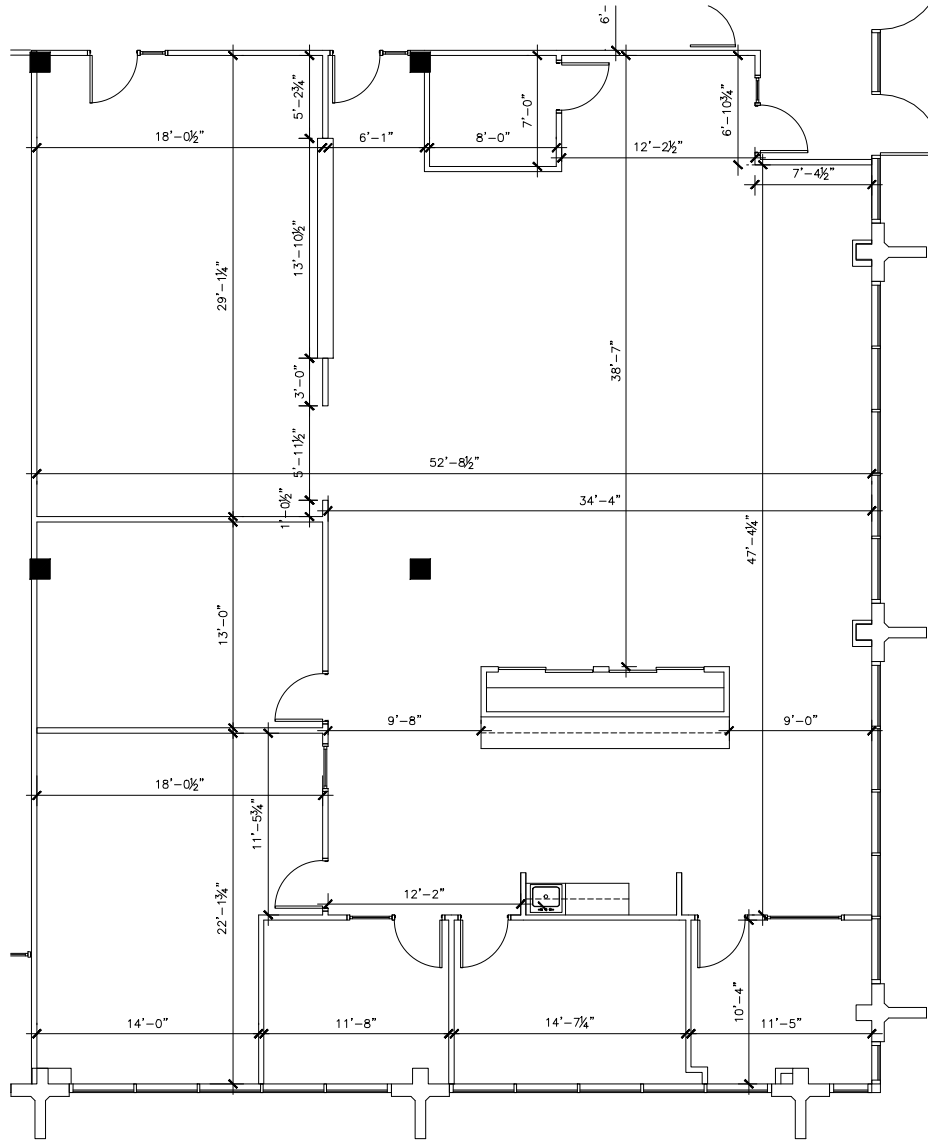

09/19/25

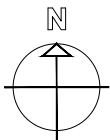

999 E. Touhy Avenue,
Des Plaines, Illinois 60018

As Built

Suite 163

